



City of Doral
ITB 2025-21
Doral Meadow Park Playground Renovation
Addendum No. 5

September 30, 2025

The original Invitation to Bid (ITB) documents shall remain in full force and effect, except as modified herein, which shall take precedence over any contrary provisions in the prior documents.

I. The following are answers to questions from prospective proposers.

1. Q. Is there a Bid Bond required for this ITB?

A. As per Section 2.8 of the ITB, bidders shall be required to submit a Bid Bond equal to five percent (5%) of the base bid.

An Original (Physical) Bid Bond shall be submitted to and received by the City Clerk's Office in a sealed envelope no later than the submittal due date of October 7, 2025 before 2:00pm at:

**City Clerk
City of Doral
8401 NW 53 Terrace
Doral, FL 33166**

Digital Bid Bonds will not be accepted, only Original (Physical) Bid Bond shall be submitted to the City Clerk's Office.

2. Q. Sheet L111 specifies 6' wide double swing gates with self-closing hinges. Double swing gates cannot be installed with self-closing hinges unless it has a center latch post. Specify whether the gates should have standard hinges without a center post, or if they should have self-closing hinges with a center latch post.

A. Gates have been revised to all be single swing gates with self-closing latch, 48" single swing, self-closing gate hinges. See L111 for updated notes.

3. Q. The drawing does not clearly specify the spacing between the posts. Could you please confirm the required spacing?

A. Please use 6ft. spacing for fence posts per reference note F-01/L111, detail 4/L701 updated to reflect spacing.

4. Q. In the plan notes, the chain link fabric is mentioned, but the minimum gauge accepted is not clearly visible. Could you please reaffirm the minimum gauge required?

A. 9 gauge fabric is desired.

5. Q. The fence shown in the plans is specified at 3'-6" height. This is not a common size and seems like a special order. Could we instead consider working with a 4'-0" chain link fence?
- A. **Detail has been revised, please use 4'-0" fence height**
6. Q. Regarding the support system, will this require engineering and structural calculations?
- A. **Footings for fence will not require structural review so long as they are constructed to the contract documents and meet standard Miami Dade County and Florida Building Code standards.**
7. Q. What is the thickness and specifications of the aggregate under artificial turf and PIP?
- A. **AASHTO #57 Drain Rock (variable thickness) per civil drawings, C-05 Typical Playground Turf Section. Thickness will vary per the civil subsurface drainage.**
8. Q. Could you kindly provide the cost of the playground equipment?
- A. **\$359,405.04**
9. Q. Is the playground equipment purchased by the city not included in the \$1,219,969.04 budget?
- A. **Not included**
10. Q. This project has a duration of 180 days. Should we include a schedule for completion date with the offer?
- A. **The 180 calendar days is a place holder, the final amount will be determined later with a maximum of 180 calendar days to complete the job.**
11. Q. Sheet L702 has two details, No. 2 and No. 3, each with a different type of curb and concrete reinforcement. Could you show the sections where these details are applied?
- A. **See L111 for section callouts of the details. Detail 03/L702 has been updated to reflect the typical 6" ribbon curb. Detail 03/L701 shows the typical ribbon curb and reinforcing detail.**
12. Q. Can you provide the reinforcement specifications for Detail No. 3 concrete curb?
- A. **See specification 32 13 13 – Concrete Paving and specification 03 30 00 Cast-in-Place Concrete for reinforcement.**

13. Q. Sheet L702 has two details, No. 2 and No. 3, each with a different type of curb and concrete reinforcement. Which of the two details will be used to enclose the artificial turf?
- A. **Detail 03/L702 has been revised, please use standard detail 03/L701 6" Ribbon Curb, Flush for the curb to enclose the artificial turf.**
14. Q. What amount should we place in item 101-18 Revised playground Equipment Drawings (Allowance) of the bid price sheet (page 37 of the solicitation)?
- A. **The bid sheet was updated, there will be a dedicated allowance if the drawings need to be revised.**
15. Q. Can the architect please provide the clarification for the Trash receptacle sizes. Are the trash receptacle 32-gallon?, please specify the covers. Are they dome or Bonnet top?
- A. **32 Gallon flat top.**
16. Q. Can the architect please clarify whether a center arm rest will be required for the benches?
- A. **No arm rest.**
17. Q. There is a round circle on the concrete at the West entrance, Can the architect please clarify what is this piece of furnish?
- A. **Existing water fountain to remain, drawing has been updated to note.**
18. Q. Please confirm if the bid due date for this project can be extended to allow sufficient time for pricing and proposal preparation.
- A. **Due date to submit bids has been extended from October 2, 2025 at 2:00pm to October 7, 2025 at 2:00pm. All bid submittals MUST be uploaded electronically to DemandStar.**
19. Q. Please provide details on the project phasing requirements.
- A. **The project will not have phases, needs to be completed at once.**
20. Q. Confirm the permitted working hours for this project.
- A. **Please review Section 2.1.0 of the Solicitation for working hours.**
21. Q. Clarify the noise barrier and temporary protection requirements.
- A. **Work area is to be protected with a temporary 6ft chain link fence to prevent access into area by the public.**

22. Q. Please confirm the designated location for the staging area.

A. The staging will be within the general site plan area. Additional staging area cannot be guaranteed.

23. Q. Please confirm whether a quote is needed for the sail shades and site furnishings, or if these items will be provided by the City.

A. Shade sails and site furnishings are to be provided by contractor.

24. Q. Please confirm the required fence fabric gauge (e.g., 6ga or 9ga) and specify whether terminal and line posts should be 2 1/2" or 3".

A. 9 gauge for fabric, 2-3/8" OD terminal posts.

II. Attached is the revised "BID PRICE SHEET" this version replaces original in the ITB solicitation and shall be utilized to provide the bid pricing.

III. Attached is support documentation from the engineer of record.

If you should have any questions regarding this addendum, please do not hesitate to contact us at procurement@cityofdoral.com.

Sincerely,

Roman Martinez, MBA, CPPO, CPPB
Procurement and Asset Management Director

BID PRICE SHEET

Item	Description	Unit	Qty.		Unit Price	Cost
101-1	Mobilization (including transportation of the equipment from storage to the site)	LS	1			
101-2	Demolition	LS	1			
101-3	Grading/Drainage	LS		1		
101-4	Utilities (replumb water fountain & re-rout water lines)	LS		1		
101-5	Playground Equipment (shade sails columns & installation, footings & foundations, hardware & fasteners, assembly and construction of equipment)	LS		1		
101-6	Concrete Paving	SF		1,600		
101-7	Concrete Curb	SF		555		
101-8	Synthetic Turf Surfacing	SF		11,000		
101-9	Poured in Place Surfacing	SF		1,300		
101-10	Landscape	LS		1		
101-11	Electrical	LS		1		
101-12	Benches	EA		15		
101-13	Trash Receptacles	EA		4		
101-14	Fence	LF		515		
101-15	Gates (double hung)	EA		3		
101-16	Gates (single)	EA		1		
101-17	Project Soft Cost (general conditions, contractor oh/p)	LS		1		
Note:	the unit pricing and total cost must account for all equipment, materials, and installation.					

TOTAL BASE BID:

**Dedicated Allowance (2% of Base Bid) for PERMITTING
and Revised Playground Equipment Drawing:**

**Contingency (10% of Base Bid) for UNFORSEEN
CONDITIONS:**

**TOTAL BID (Base Bid + Dedicated Allowance +
Contingency):**

NOTE 5% BID BOND MUST BE SUBMITTED TO THE CITY CLERK'S OFFICE**ON OCTOBER 7, 2025 BEFORE 2:00PM**

addendum

No. 5 - Support Documentation

Project: 215618515
Date: September 29, 2025
Issued By: Mark Beer

Re: Doral Meadow Park Playground Improvements - Addendum 05

This Addendum is issued to provide clarification, modifications, and additional information to the Contract Documents. The items outlined herein are intended to supplement, modify, or supersede the original documents where noted. All other requirements of the Contract Documents remain unchanged. Contractors shall incorporate the provisions of this Addendum into their work and pricing as applicable.

1. Clarifications/Revisions

- L111 – Site Materials Plan (sheet reissued)
 - Reference Note G-01 updated to read:
 - Gate – Single Swing, Chain Link, Black Vinyl Coated, Self Closing, Magnalatch or similar hardware. 4'-0" clear, ADA accessible.
 - Reference Note G-02 struck from reference schedule
 - Reference Note MS-07 added to reference schedule
 - Existing water fountain to remain
 - Drawing revised to show single swing gates at all entry points
- L701 – Site Details (sheet reissued)
 - Detail 04 updated
 - Fabric gauge revised to 9 gauge
 - Dimension, height of fence revised to 4'-0"
 - Dimension, post spacing, revised 6'-0" typ.
 - Terminal Post OD updated
 - Notation for concrete footers revised
- L702 – Site Details (sheet reissued)
 - Detail 03 updated
 - Concrete curb updated to reflect ribbon curb in detail 02/L702 and standard detail 03/L701.
 - Notation for curb updated
 -

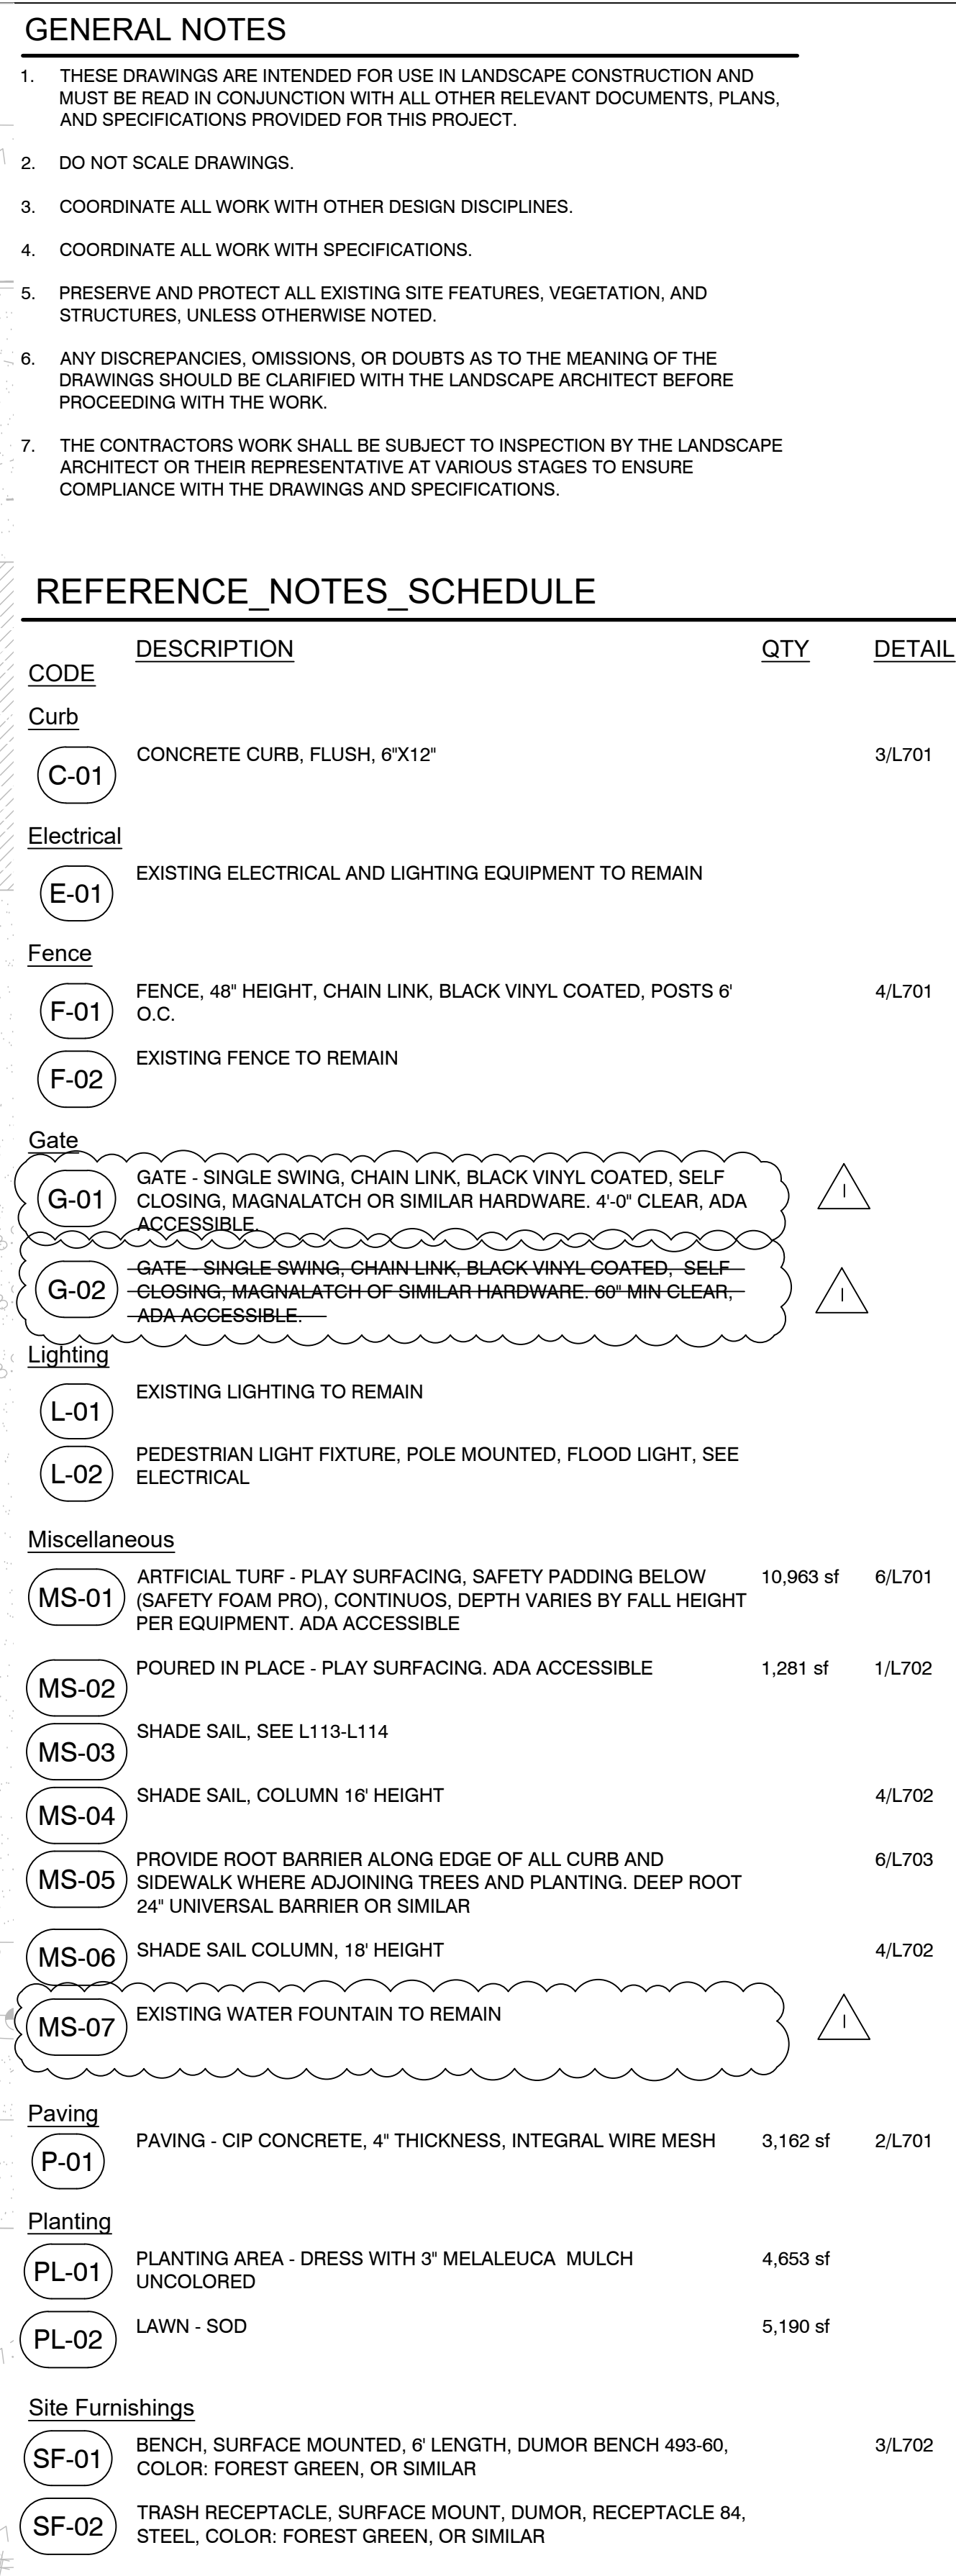
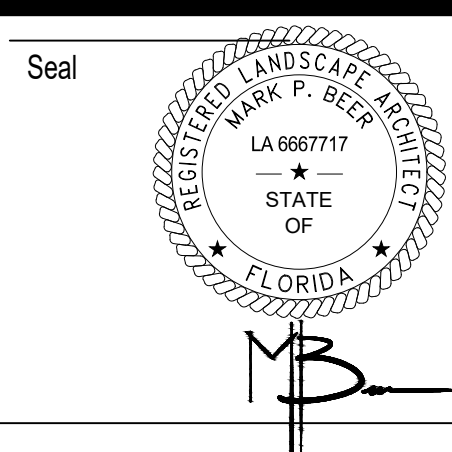
2. Questions/Responses

- Bidder questions are addressed on response form provided by city.

3. Attachments

- L111 – Site Materials Plan
- L701 – Site Details
- L702 – Site Details

End of Addendum

[illegible]

FRM|NRK

10 1/2 South Main Street
Zionsville, IN 46077
W: www.frmwrkdesign.com



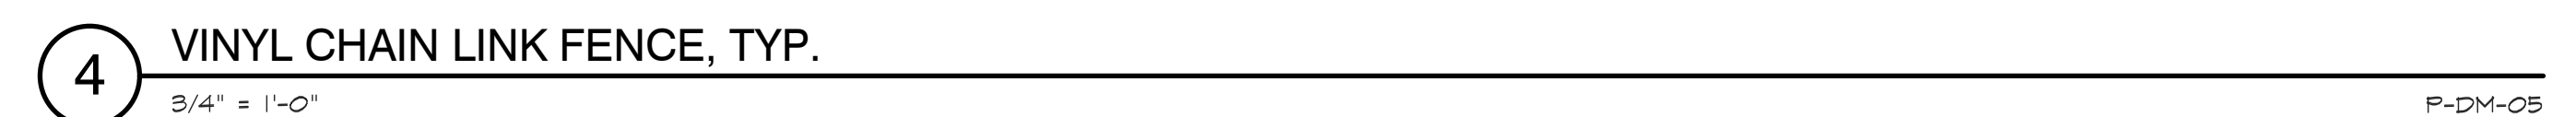
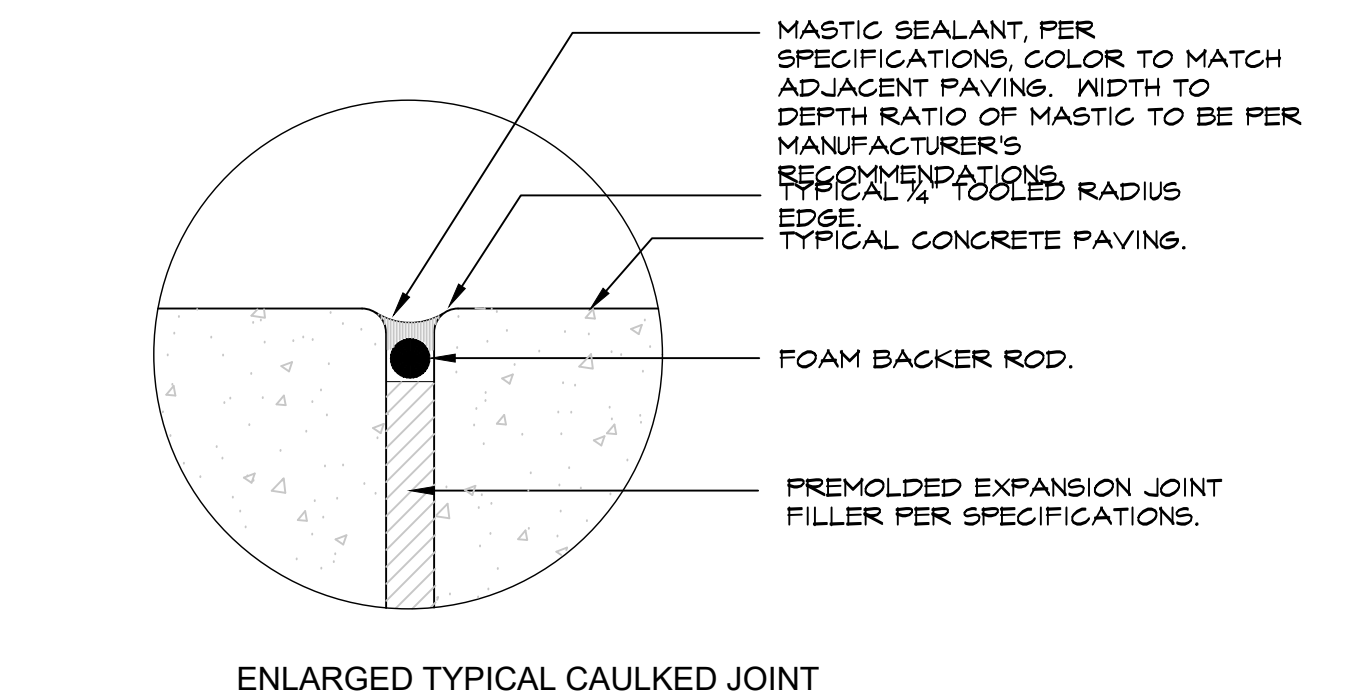
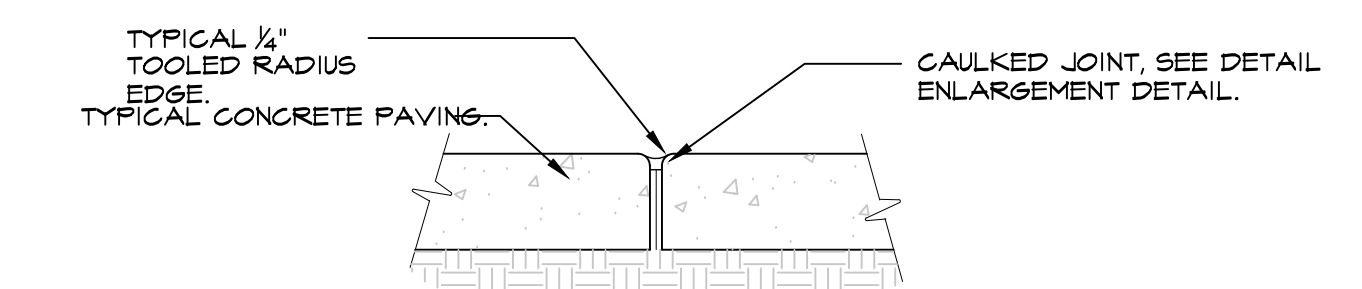
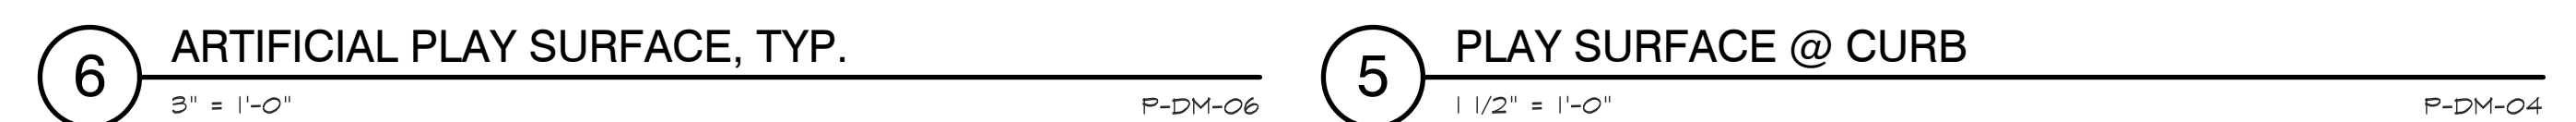
CITY OF DORAL

DORAL MEADOW PARK PLAYGROUND IMPROVEMENTS

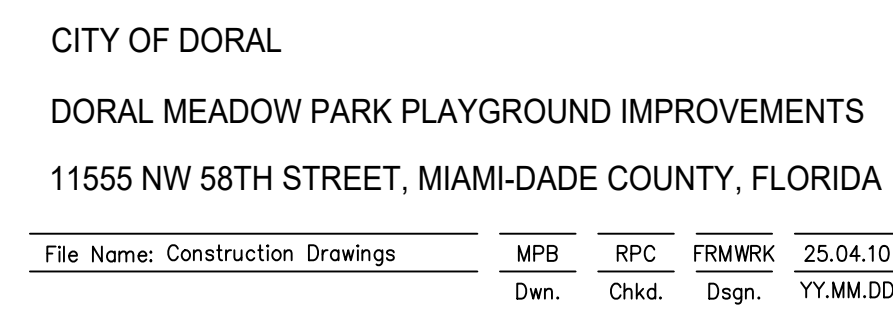
11555 NW 58TH STREET, MIAMI-DADE COUNTY, FLORIDA

File Name: Construction Drawings	MPB	RPC	FRMWRK	25.04.10
	Dwn.	Chkd.	Dsgn.	YY.MM.DD

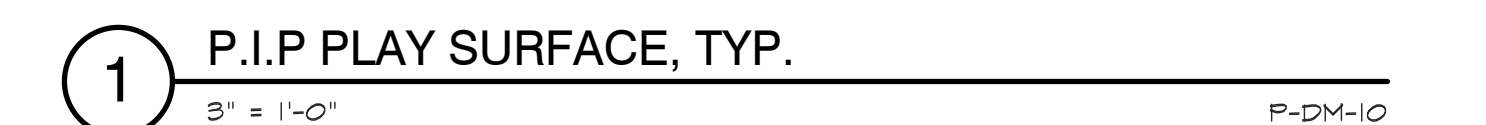
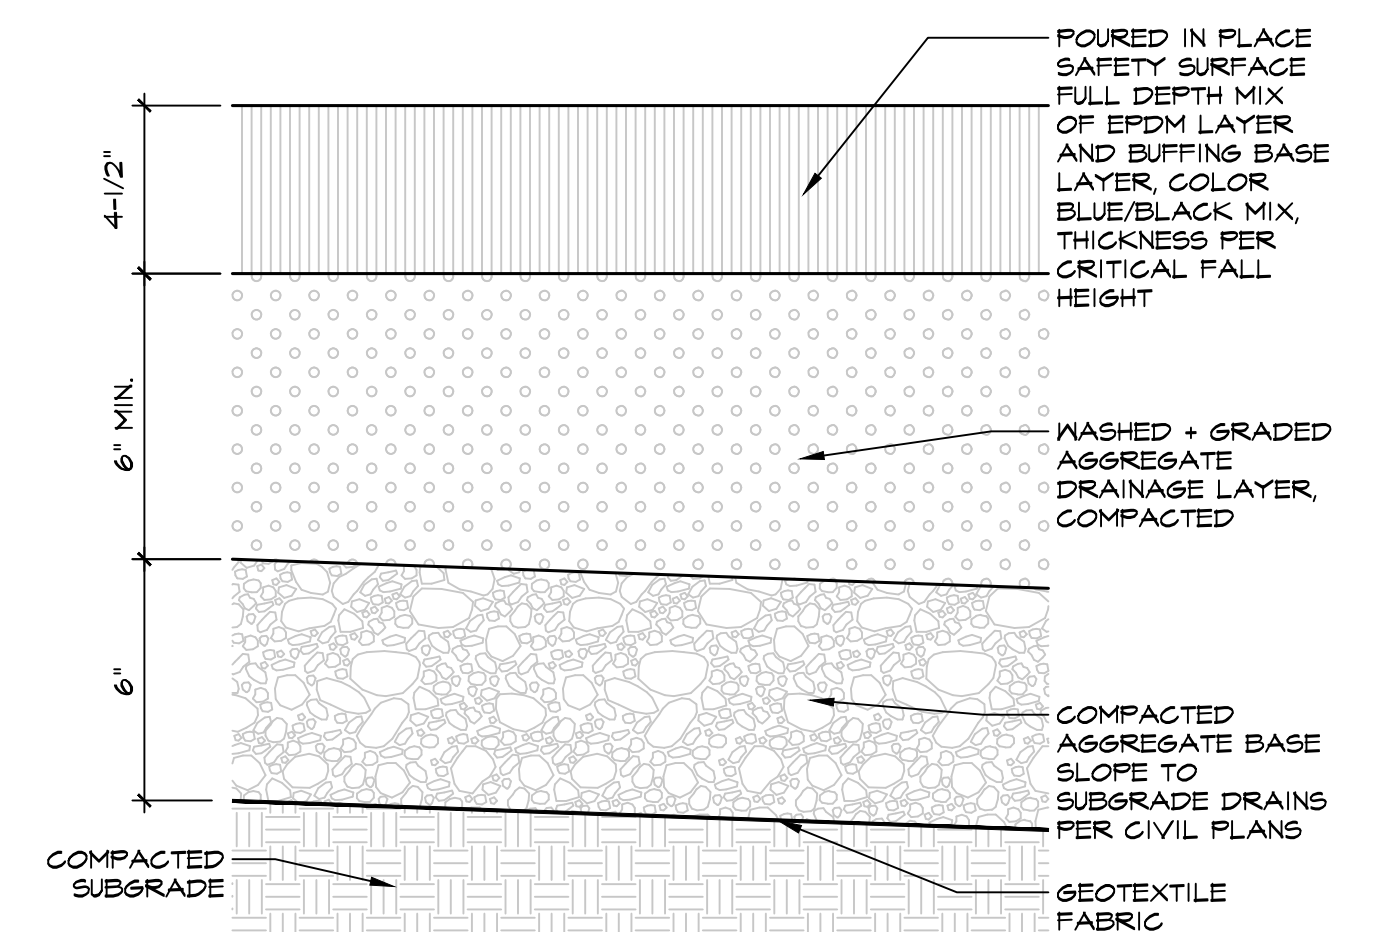
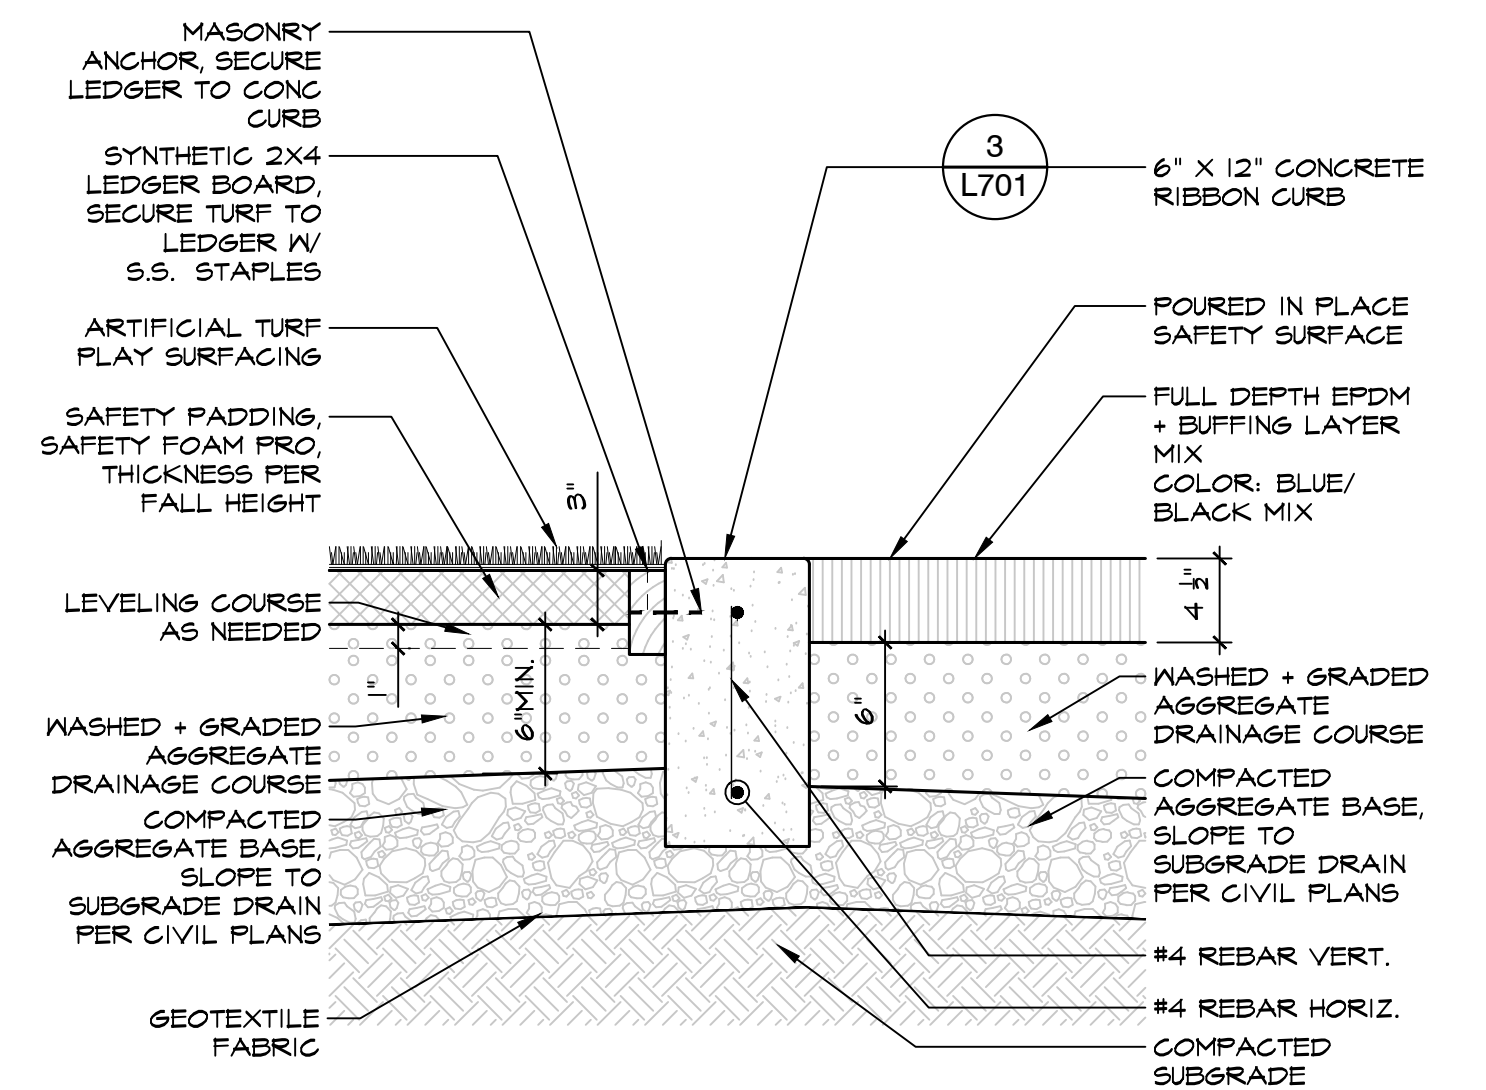
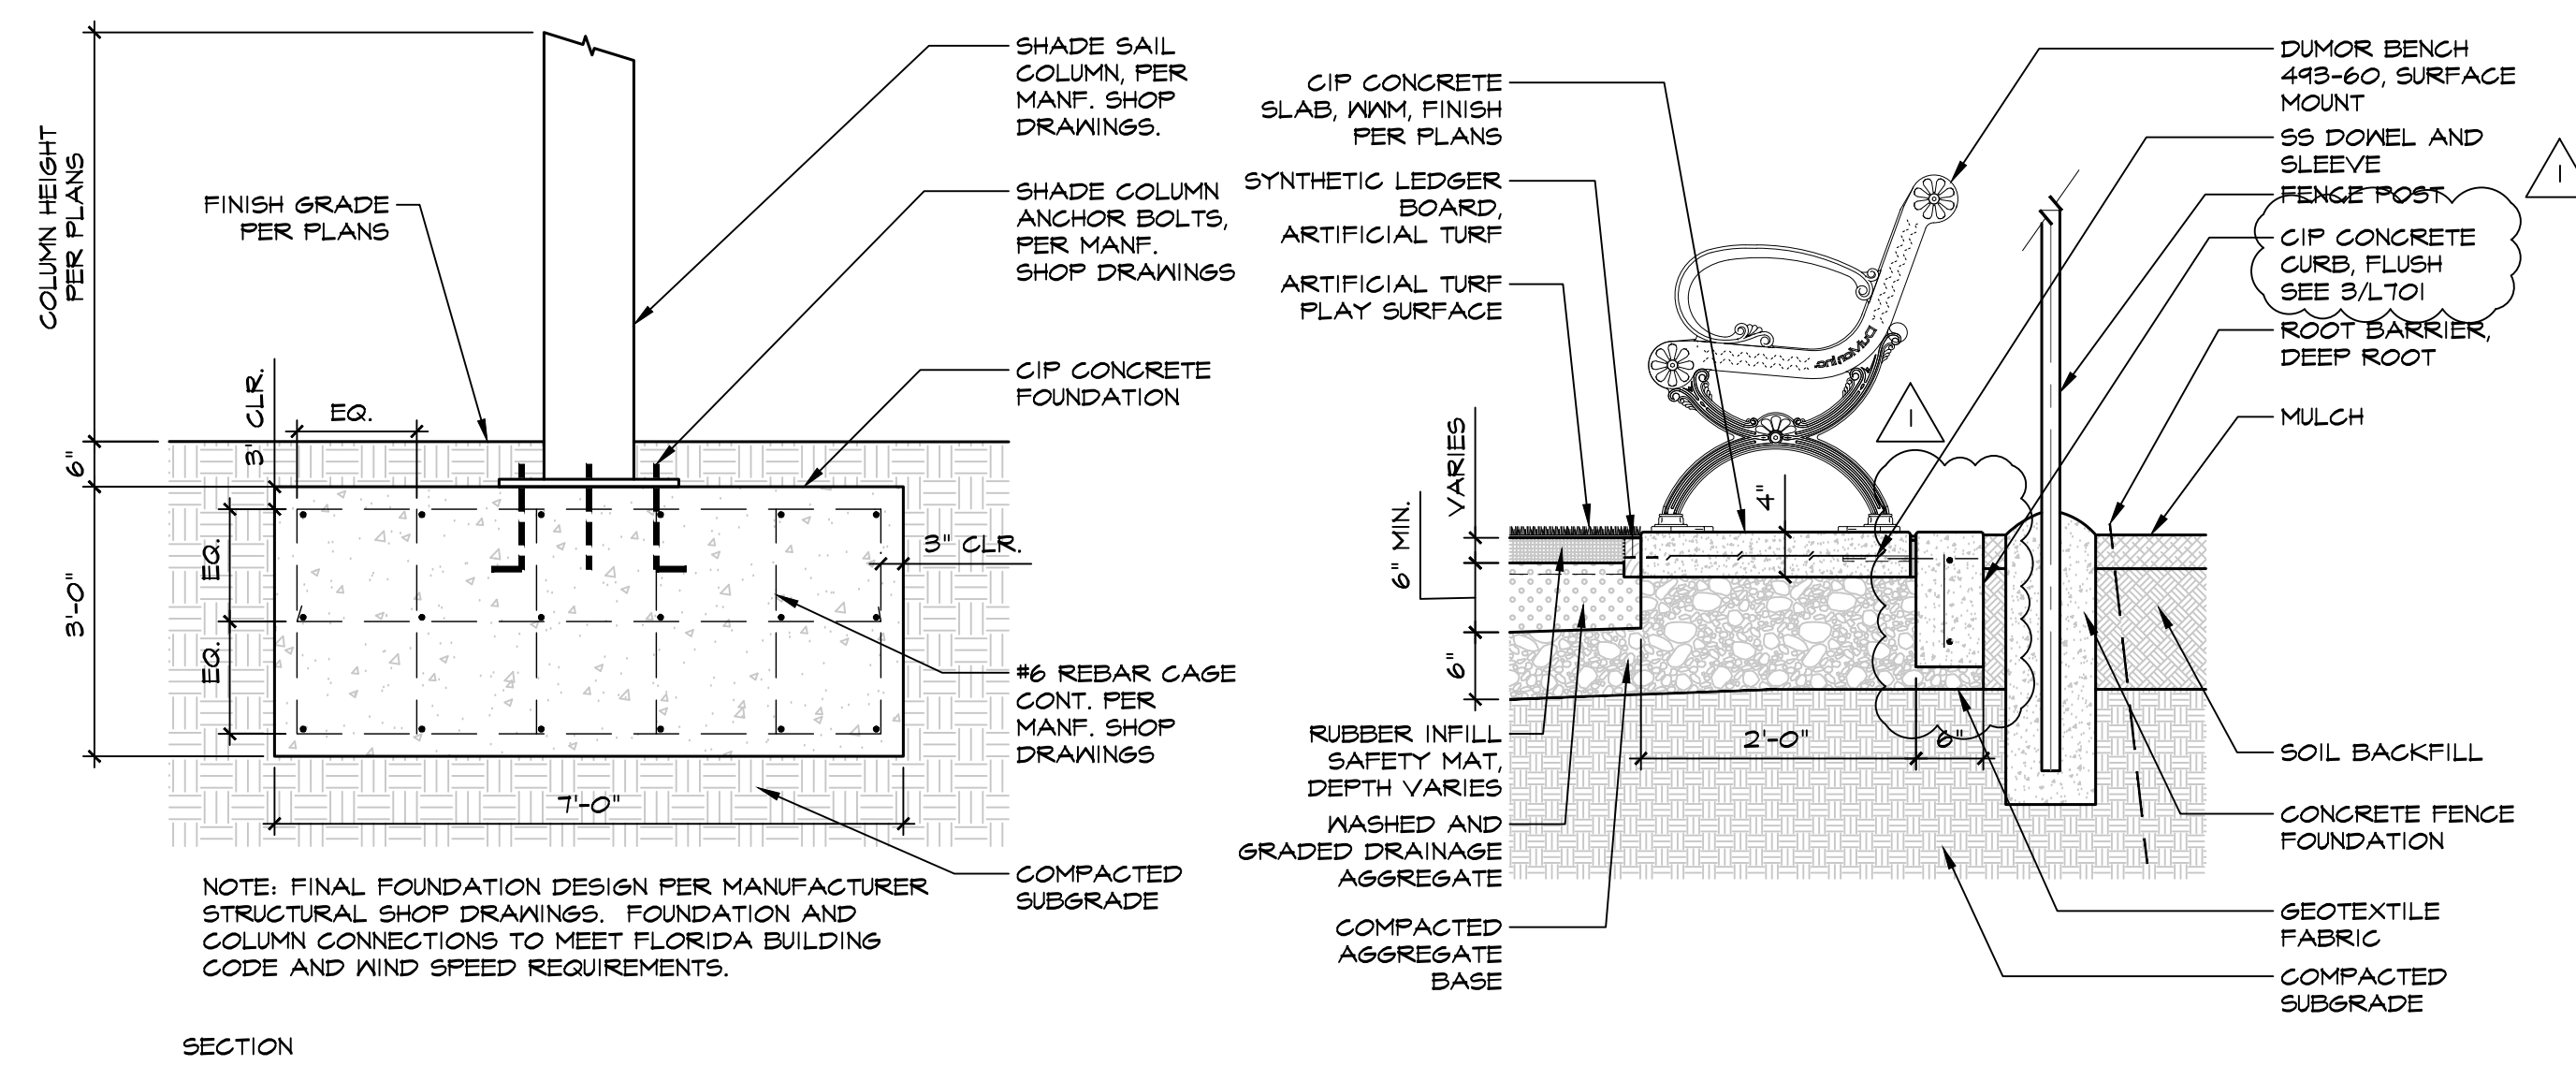
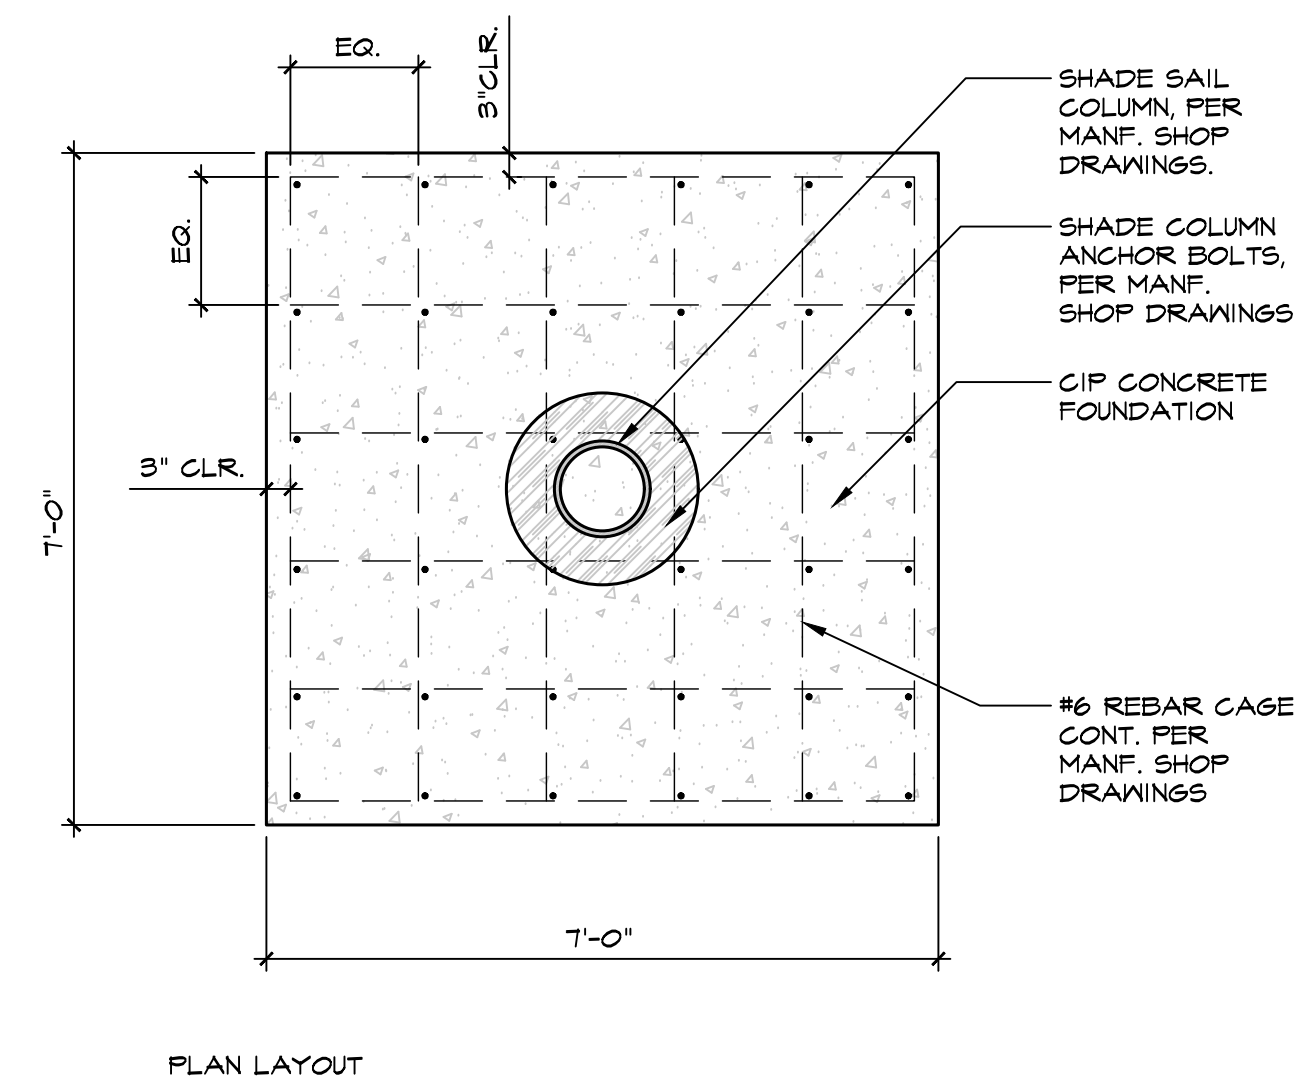
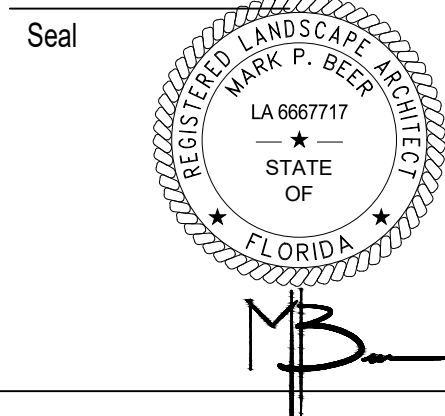
SITE MATERIALS PLAN		
Project No.	Scale	
215618515 / 23P005	1" = 10'	
Drawing No.	Sheet	Revision
	L111	



Construction Drawings	FRMWK		25.04.10
100% Construction Drawings	FRMWK		24.12.11
90% Construction Drawings	FRMWK		24.11.05
50% Construction Drawings	FRMWK		24.06.21
100% Design Development Drawings	FRMWK		24.04.26
50% Design Development Drawings	FRMWK		24.03.29
Issued	By	Appd.	YY.MM.DD



SITE DETAILS		
Project No.	Scale	
215618515 / 23P005	1"=10'	
Drawing No.	Sheet	Revision
	L701	

[illegible]

FRM | WRK

10 1/2 South Main Street
Zionsville, IN 46077
W: www.frmwrkdesign.com



CITY OF DORAL

DORAL MEADOW PARK PLAYGROUND IMPROVEMENTS

11555 NW 58TH STREET, MIAMI-DADE COUNTY, FLORIDA

File Name: Construction Drawings	MPB	RPC	FRMRWK	25.04.10
	Dwn.	Chkd.	Dsgn.	YY.MM.DD

SITE DETAILS		
Project No.	Scale	
215618515 / 23P005	1"=10'	
Drawing No.	Sheet	Revision
	L702	